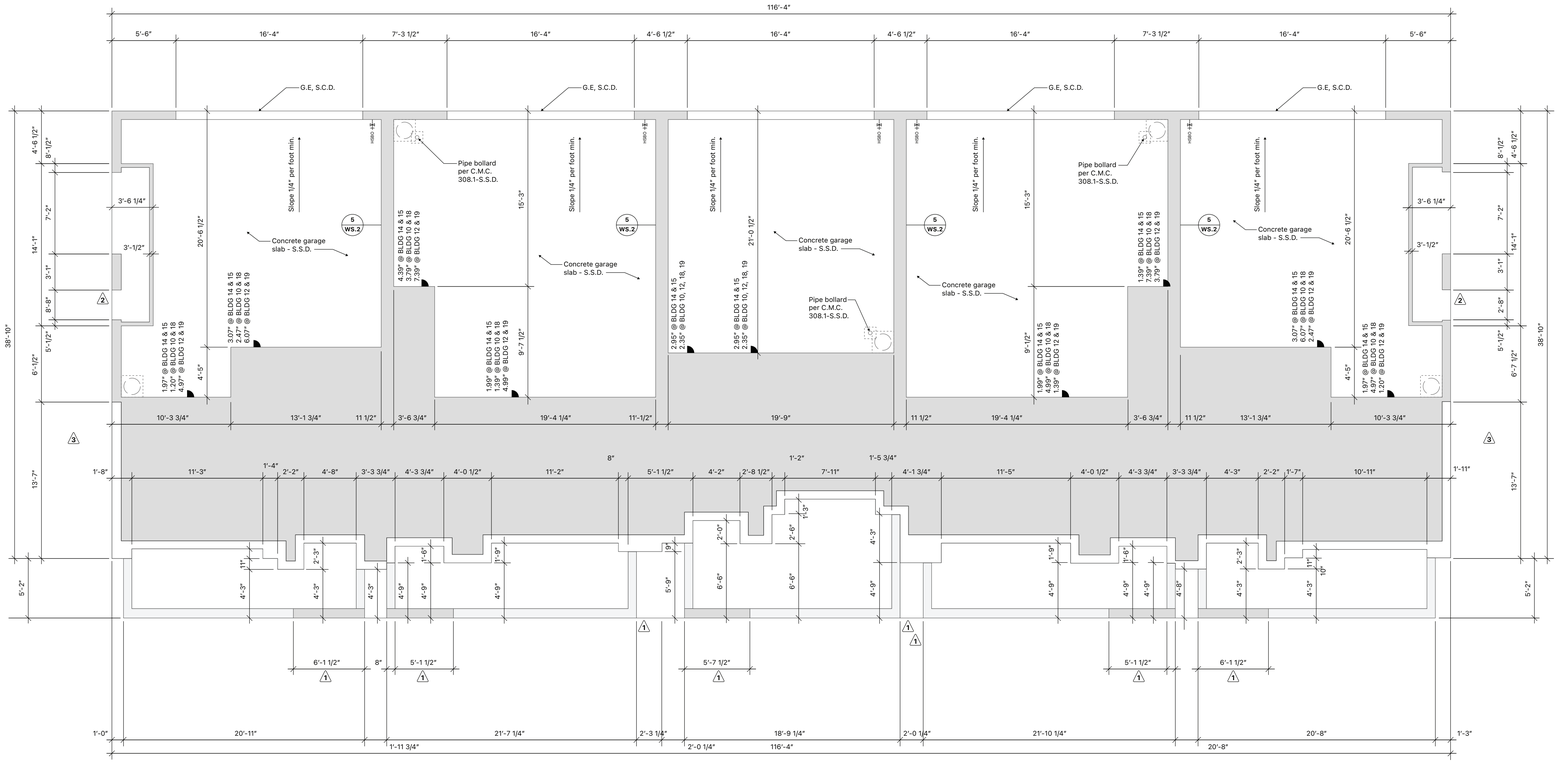


SLAB INTERFACE PLAN


Scale: 3/16" = 1'-0"

SLAB INTERFACE PLAN WALL LEGEND

- CONC. WALL @ +3.43' ABV. FFE-G, TYP. (3)
- CONC. FND. WALL @ +4.15' ABV. FFE-G, TYP.
- SLAB DEPRESSED 1" BELOW FFE-G, TYP.
- CONC. WALL @ +3.25' ABV. FFE-G @BLDG 10 & 12, TYP. @ +1.11' ABV. FFE-G @BLDG 14 & 15, TYP. @ +2.15' ABV. FFE-G @BLDG 18, TYP. @ +1.15' ABV. FFE-G @BLDG 19, TYP.

ABBREVIATIONS (1)

FFE-G = FINISHED FLOOR ELEVATION AT GROUND FLOOR
GE = GARAGE ELEVATION AT LIP

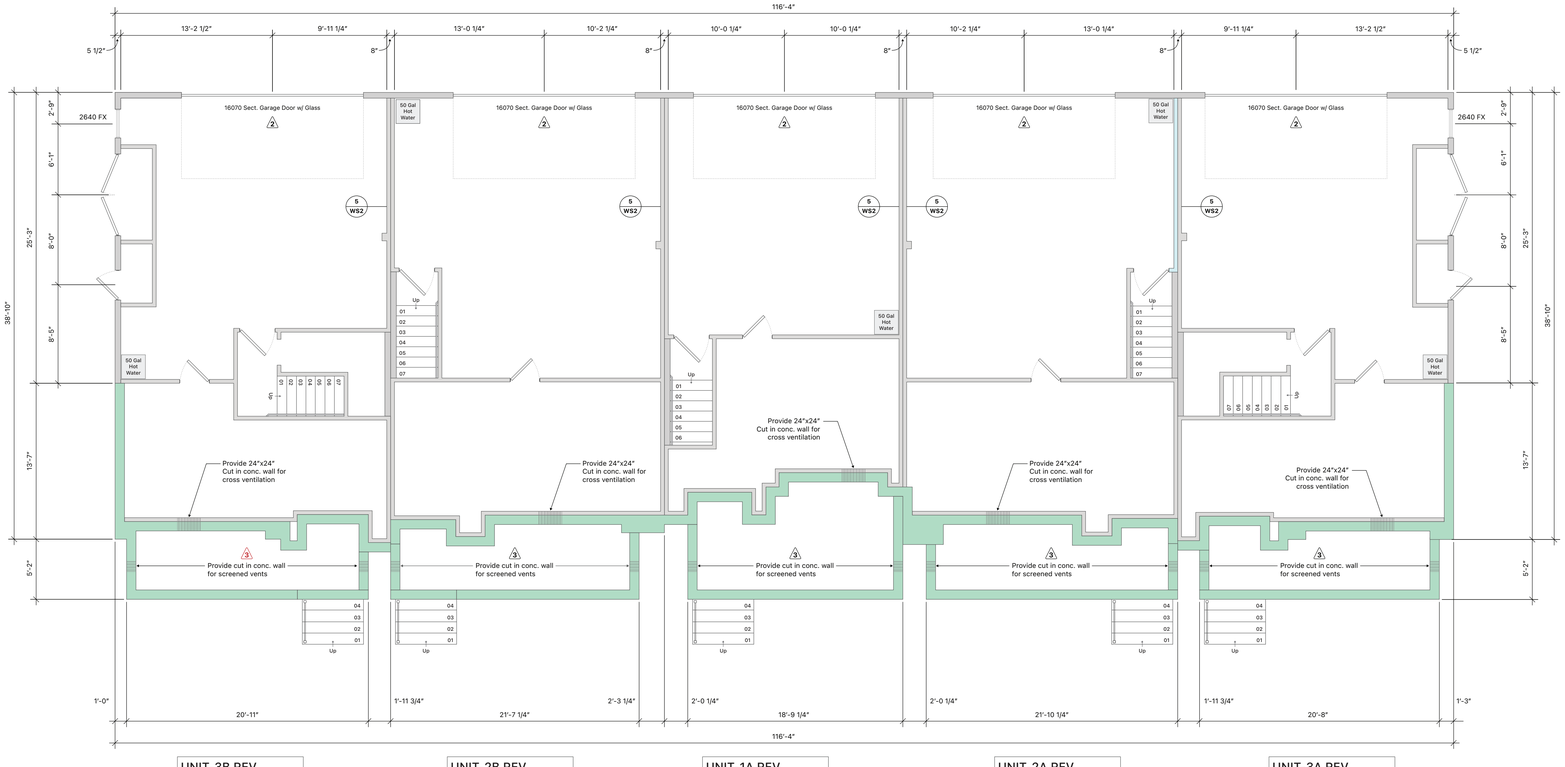

FIRST FLOOR PLAN

Scale: 3/16" = 1'-0"

UNIT-3B REV.

FOR ADDITIONAL NOTES, DIMENSIONS & DETAILS FOR THIS UNIT REFER TO ITS TYPICAL PLAN, UNIT 3 SHT. .1A & .1B

UNIT-2B REV.

FOR ADDITIONAL NOTES, DIMENSIONS & DETAILS FOR THIS UNIT REFER TO ITS TYPICAL PLAN, UNIT 2 SHT. .1A & .1B

UNIT-1A REV.

FOR ADDITIONAL NOTES, DIMENSIONS & DETAILS FOR THIS UNIT REFER TO ITS TYPICAL PLAN, UNIT 1 SHT. .1A & .1B

UNIT-2A REV.

FOR ADDITIONAL NOTES, DIMENSIONS & DETAILS FOR THIS UNIT REFER TO ITS TYPICAL PLAN, UNIT 2 SHT. .1A & .1B

UNIT-3A REV.

FOR ADDITIONAL NOTES, DIMENSIONS & DETAILS FOR THIS UNIT REFER TO ITS TYPICAL PLAN, UNIT 3 SHT. .1A & .1B

Wall Legend

- 2x4 WD. Stud wall
- 2x6 WD. Stud wall
- Concrete retaining walls
- 2x WD. Stud partial height wall. Height per plan
- Soffit or furred ceiling
- Pot shelf
- (3) Are of RC channel installation

Glazing Notes

- All glazing is fixed (U.O.N)
- All glazing is dual pane insulating glass.
- (1) (2) Windows marked with a (E) shall be 3/16" thick Meet egress by the manufacturer.
- (1) (2) Glazing marked with a (T) shall be 3/17" thick Tempered safety glass
- HDR. HT.:
  1st Floor: = 8'-0" U.O.N.
  2nd Floor: = 8'-0" U.O.N.
  3rd Floor: = 8'-0" U.O.N.

ACME ARCHITECTS

Acme Architects, Inc.
Architecture / Planning




Slab Interface Plan & First Floor Plan

Revisions


(1) Plan check comments: 09-24-2021
(2) Client revisions / RSOA comments 11-18-2021
(3) Framewalk revisions: 01-22-2022

SET DATE:	01-22-2022
ISSUE DATE:	07-28-2021
SCALE:	As noted
DRAWN:	JLR, JSC, TW
JOB	310392

PM: JR | **QC:** JR | **OL:** TW


PLAN **BLDG** SHEET .1A OF SHEETS

DO NOT SCALE THESE DRAWINGS

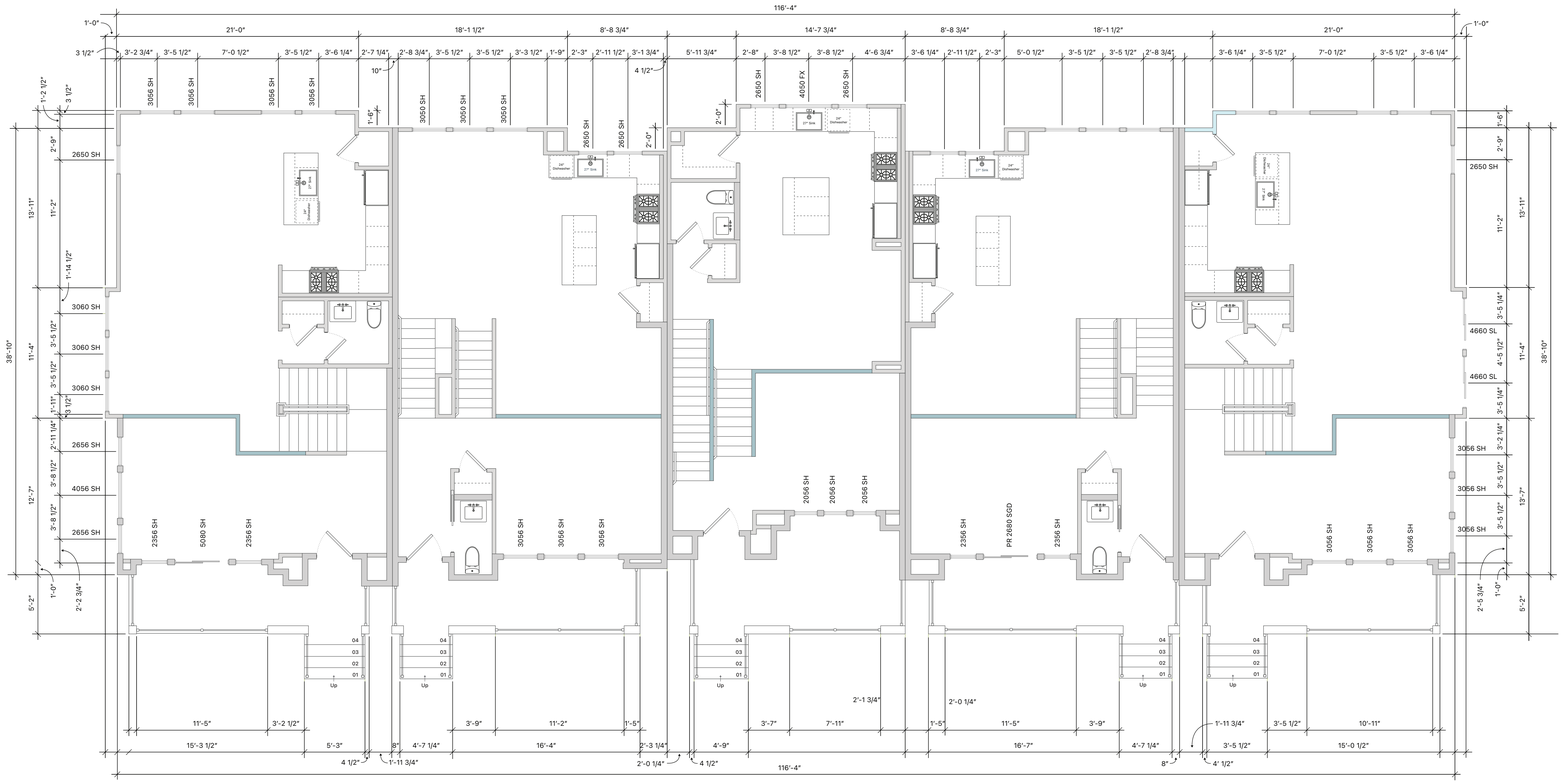

SECOND FLOOR PLAN

Scale: 3/16" = 1'-0"

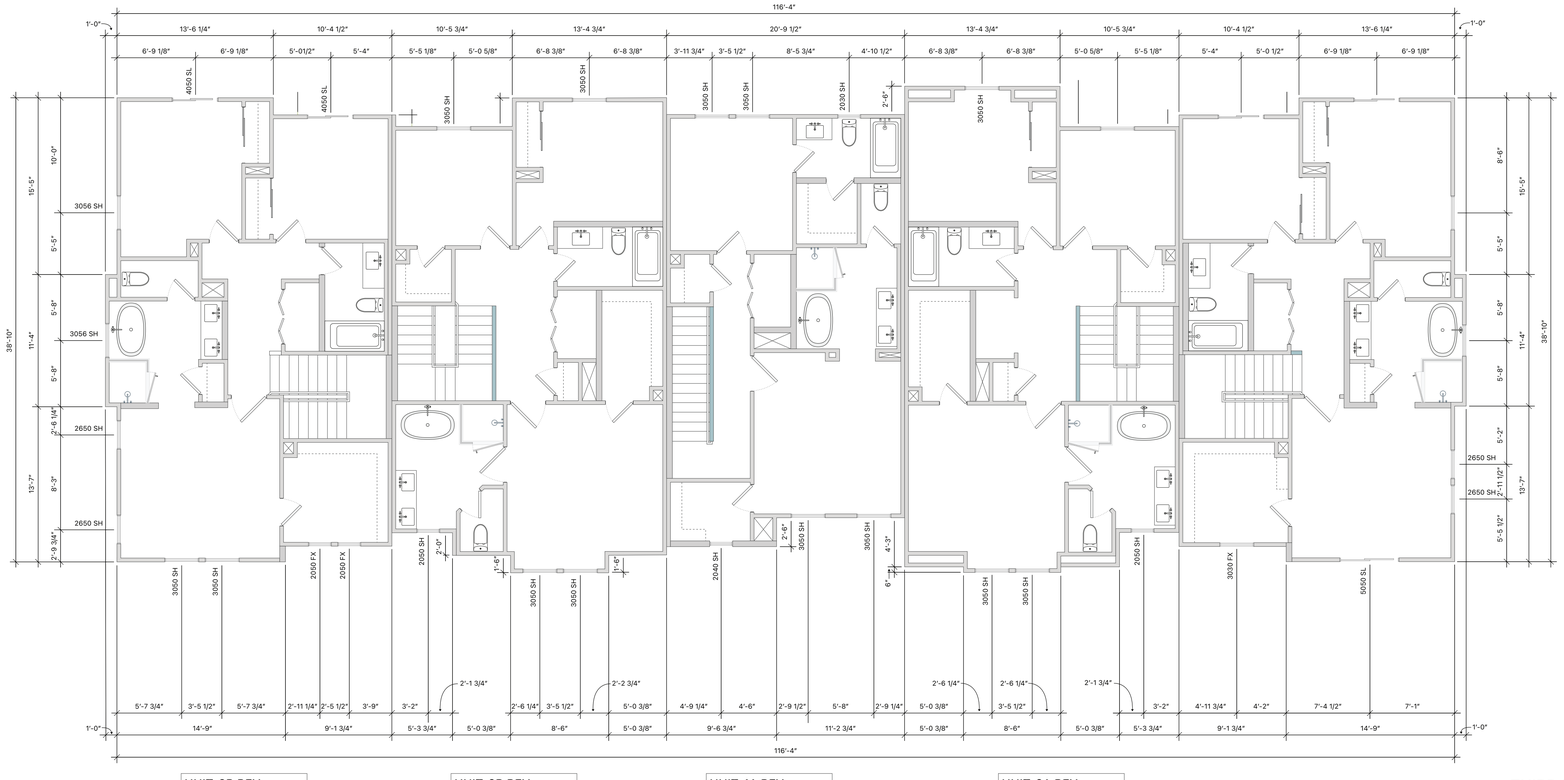

THIRD FLOOR PLAN

Scale: 3/16" = 1'-0"

UNIT-3B REV.
FOR ADDITIONAL NOTES, DIMENSIONS & DETAILS FOR THIS UNIT REFER TO ITS TYPICAL PLAN, UNIT 3 SHT. .1A & .1B

UNIT-2B REV.
FOR ADDITIONAL NOTES, DIMENSIONS & DETAILS FOR THIS UNIT REFER TO ITS TYPICAL PLAN, UNIT 2 SHT. .1A & .1B

UNIT-1A REV.
FOR ADDITIONAL NOTES, DIMENSIONS & DETAILS FOR THIS UNIT REFER TO ITS TYPICAL PLAN, UNIT 1 SHT. .1A & .1B

UNIT-2A REV.
FOR ADDITIONAL NOTES, DIMENSIONS & DETAILS FOR THIS UNIT REFER TO ITS TYPICAL PLAN, UNIT 2 SHT. .1A & .1B

UNIT-3A REV.
FOR ADDITIONAL NOTES, DIMENSIONS & DETAILS FOR THIS UNIT REFER TO ITS TYPICAL PLAN, UNIT 3 SHT. .1A & .1B

Wall Legend

- 2x4 WD. Stud wall
- 2x6 WD. Stud wall
- Concrete retaining walls
- 2x WD. Stud partial height wall. Height per plan
- Soffit or furred ceiling
- Pot shelf
- (3) Are of RC channel installation

Glazing Notes

- All glazing is fixed (U.O.N)
- All glazing is dual pane insulating glass.
- (1) Windows marked with a (E) shall be 3/16" thick Meet egress by the manufacturer.
- (1) Glazing marked with a (T) shall be 3/17" thick Tempered safety glass
- HDR. HT.:
  1st Floor: = 8'-0" U.O.N.
  2nd Floor: = 8'-0" U.O.N.
  3rd Floor: = 8'-0" U.O.N.

ACME ARCHITECTS

Acme Architects, Inc.
Architecture / Planning

3361 Walnut Blvd. Ste. 120
Brentwood, CA 94513
(925) 634-7000

The Preserve & Salt Court Townhomes

Redwood City, CA

Conceptual design by Acme Architects

Second & Third Floor Plans

Revisions


- (1) Plan check comments: 09-24-2021
- (2) Client revisions / RSOA comments 11-18-2021
- (3) Framewalk revisions: 01-22-2022

SET DATE:	01-22-2022
ISSUE DATE:	07-28-2021
SCALE:	As noted
DRAWN:	JLR, JSC, TW
JOB	310392

PM: JR | **QC:** JR | **OL:** TW


PLAN **BLDG** SHEET .1B OF SHEETS

DO NOT SCALE THESE DRAWINGS

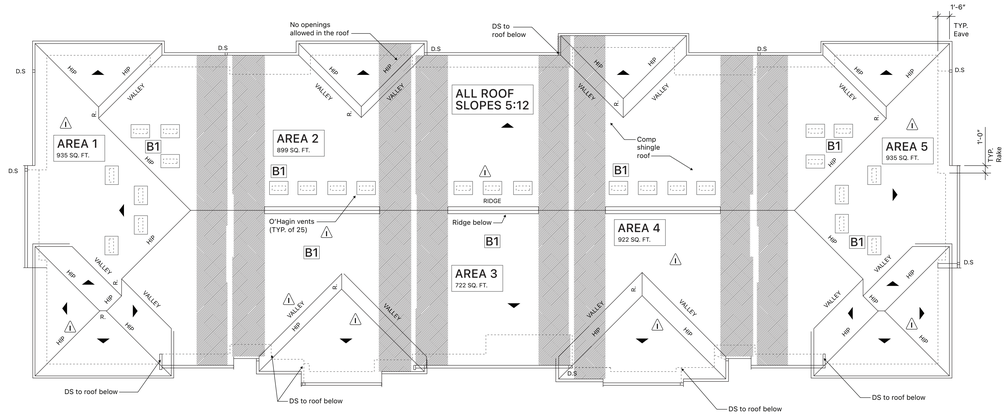


UPPER FLOOR PLAN

Scale: 1/8" = 1'-0"

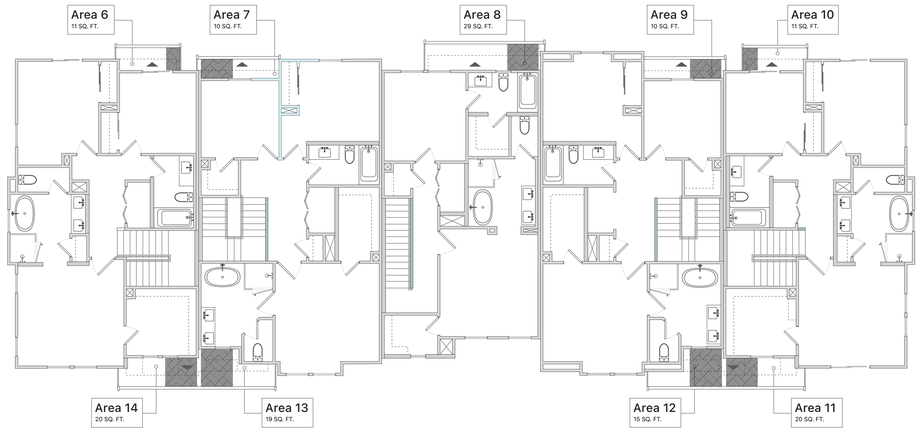

MIDDLE FLOOR PLAN

Scale: 1/8" = 1'-0"

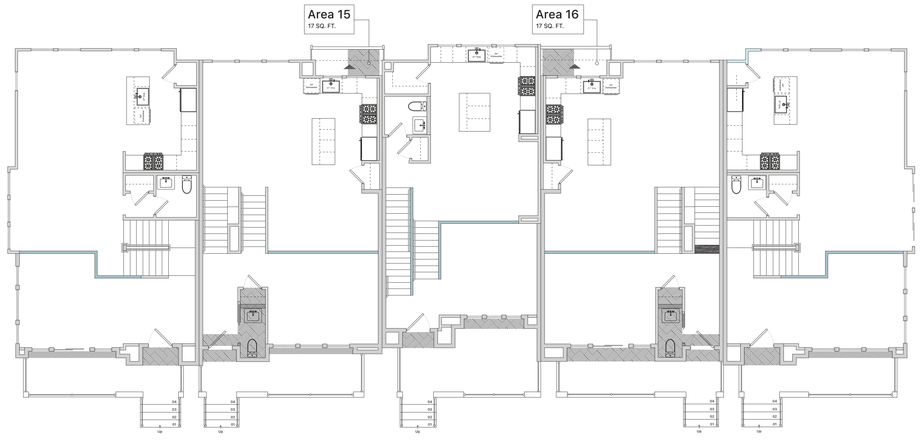

LOWER FLOOR PLAN

Scale: 1/8" = 1'-0"

ATTIC VENT NOTES

1. PROVIDE ROOF / ATTIC VENTILATION IN COMPLIANCE WITH C.B.C. SECTION I503.5 * 1203.2

2. PROVIDE VENTILATING OPENINGS FOR EACH SEPARATE SPACE OF ENCLOSED ATTICS AND ENCLOSED RAFTER SPACES, WHERE CEILINGS OCCUR AT UNDERSIDE OF ROOF FRAMING MEMBERS, WHERE SHOWN OR WHERE NOT SHOWN, TO ACHIEVE FULL CODE COMPLIANT CROSS VENTILATION.

3. PROVIDE A NET FREE VENTILATING AREA NOT LESS THAN 1/150 OF THE AREA OF THE SPACE VENTILATED, NITH 50 PERCENT OF THE REQUIRED VENTILATING AREA PROVIDED BY VENTILATORS LOCATED IN THE UPPER PORTION OF THE SPACE TO BE VENTILATED AT LEAST 3 FEET ABOVE EAVE OR CORNICE VENTS AND THE BALANCE OF THE REQUIRED VENTILATION PROVIDED BY EAVE OR CORNICE VENTS.

4. PROTECT VENTILATING OPENINGS AGAINST ENTRANCE OF RAIN AND/OR SNON.

5. BLOCKING AND BRIDGING SHALL BE ARRANGED SO AS NOT TO INTERFERE WITH AIR MOVEMENT.

6. PROVIDE I" MINIMUM OF AIR SPACE BETWEEN INSULATION AND ROOF SHEATHING.

7. PROVIDE CORROSION-RESISTANT WIRE CLOTH SCREENING, HARDWARE CLOTH, PERFORATED VINYL OR SIMILAR MATERIAL WITH OPENINGS OF 1/8" MINIMUM AND 1/4' MAXIMUM, FOR ALL EXTERIOR OPENING INTO ATTIC SPACE.

8. UPPER VENTILATION:
PROVIDE UPPER VENTILATION WITH GABLE VENTS AND/OR O'HAGIN VENTS, AS SHOWN IN ROOF PLAN AND CALCULATIONS BELON.

9. LOWER VENTILATION:
PROVIDE LONER VENTILATION WITH SCREEN VENTS AND/OR O'HAGIN VENTS, AS SHONN IN ROOF PLAN, CALCULATIONS AND NOTES BELON.

A. SCREEN VENTS: AREA = 29 SQ. IN. PER VENT FOR RAFTERS / TRUSSES @ 16" 0.c., OR 46 SQ. IN. PER VENT FOR RAFTERS / TRUSSES 24 o.C. (VERIFY NET VENTILATING AREA WITH VENT MFR. & REGALCULATE VENTILATION AS REQUIRED FOR COMPLIANCE).

NOTES:
RECALCULATE VENTILATION REQUIREMENTS FOR COMPLIANCE IF RAFTER / TRUSS BLOCKS ARE USED IN PLACE OF SCREEN VENTS. RAFTER / TRUSS BLOCKS: (3) 2" DIA. HOLES. AREA = 9.42 SQ. IN. PER BLOCK. SEE STRUCTURAL DRAWINGS FOR RESTRICTIONS DUE TO SHEAR NALL REQUIREMENTS, IF ANY.

⚠1 ALL METAL FLASHING, VENTS, FLUES, ETC. ARE TO BE PAINTED TO MATCH THE ADJACENT SURFACE.

ATTIC VENT CALCULATION

ELEVATION A:

AREA I - VENTILATION REQUIRED.
435 SF ATTIC AREA / 150 = 623 S.F
REQUIRED UPPER & LONER VENTILATION:
623 /2 = 312 5F (OR 449 51)
UPPER VENTILATION PROVIDED:
⚠1 (7) O'HAGIN VENTS & 72 SI. = 504 S..
304 5.1. PROVIDED › 449 S... REQ.D
LOWER VENTILATION PROVIDED:
(10) SCRND. VENTS @ 46 SI. = 460 S.I
460 SI. PROVIDED › 449 51. REQD

AREA 2 - VENTILATION REQUIRED:
899 S.F. ATTIC AREA / 150 = 599 S.F
REQUIRED UPPER A LOVER VENTILATION:
5,94 / 2 = 3.00 S.F. (OR 432 SI.)
UPPER VENTILATION PROVIDED:
⚠1 (4) O'HAGIN VENTS @ 72 S.I.+
15 LF. RIDGE VENT € 135 S. /LF. = 4905 5.
4905 SI. PROVIDED › 432 SI. REQ.D
LOWER VENTILATION PROVIDED:
(10) SCRND. VENTS & 46 SI. = 460 SJ
460 SI. PROVIDED › 432 S.. REQ'D

AREA 3 - VENTILATION REQUIRED:
122 S.F. ATTIC AREA / 150 = 4.8| S.F.
REQUIRED UPPER & LONER VENTILATION:
4.81 / 2 = 2.4' S.F. (OR 341 S.I)
UPPER VENTILATION PROVIDED:
⚠1 (3) O'HAGIN VENTS @ 72 5.I.
111.88 LF. RIDGE VENT ® 135 SIAF. = 376.38 SI.
376 38 SI. PROVIDED › 341 SI. REQ.D
LOWER VENTILATION PROVIDED:
(8) SCRND VENTS A 46 SI = 368 51
368 S.. PROVIDED › 347 SI. REQ'D.

AREA 4 - VENTILATION REQUIRED
922 S.F. ATTIC AREA / 150 = 6.15 SF
⚠1 REQUIRED UPPER & LONER VENTILATION:
615 / 2 = 301 S= (OR 443 GL)
UPPER VENTILATION PROVIDED:
(4) O'HAGN VENTS ® 72 5.I. +
15 LF. RIDGE VENT ® 135 S. /LF. = 4905 SI
4905 SI. PROVIDED › 443 SI. REQ 'D
LOWER VENTILATION PROVIDED:
(10) SCRND. VENTS @ 46 SI. = 460 S.I.
460 SI. PROVIDED › 443 SI. RECD

AREA 5 - VENTILATION REQUIRED:
935 S.F. ATTIC AREA / 50 = 6.23 5.F
REQUIRED UPPER & LONER VENTILATION:
623 / 2 = 312 5F (OR 444 51)
UPPER VENTILATION PROVIDED:
(7) O'HAGIN VENTS a 72 SI. = 504 5J
494 SI. PROVIDED › 449 SI. REQ.D
LOWER VENTILATION PROVIDED:
(10) SCRND. VENTS @ 46 S... = 460 SI
4GO SI. PROVIDED > 440 51. REOD

AREA 6 - LOWER VENTILATION REQUIRED.
I SF. ATTIC AREA / 150 = 0.07 SF. (OR 10.6 51)
LOWER VENTILATION PROVIDED:
(1) SORND. VENTS & 46 5.1.
46 SI. PROVIDED › 106 SI REC'D.
ATTIC VENT CALCULATION

AREA 7 - LOWER VENTILATION REQUIRED:
I0 S.F. ATTIC AREA / 150 = 0.01 S.F. (OR 4.6 S...
LOWER VENTILATION PROVIDED:
(1) SCRND. VENTS @ 46 S.I.
46 SI. PROVIDED › 9.6 SI. REQ'D.

AREA 8 - LONER VENTILATION REQUIRED:
28 SF. ATTIC AREA / 150 = 019 S.F. (OR 28 S.])
LOWER VENTILATION PROVIDED:
(1) SCRND VENTS A 46 S.I.
46 SI. PROVIDED > 28 S.J. REQD.

AREA 9 - LONER VENTILATION REQUIRED:
10 S.F. ATTIC AREA / 150 = 0.01 S.F. (OR 4.6 S.]J
LOWER VENTILATION PROVIDED:
(1) SCRND. VENTS A 46 SI.
46 SI. PROVIDED › 9.6 SI. REQ'D

AREA 10 - LOWER VENTILATION REQUIRED.
II SF. ATTIC AREA / 150 = 0.07 S.F. (OR 10.6 S.I)
LOWER VENTILATION PROVIDED:
(1) SORND. VENTS @ 46 S.I.
46 SI. PROVIDED › 10.6 SI. REQ'D.

AREA 11 - LOWER VENTILATION REQUIRED:
20 SF ATTIC AREA / 150 = 013 SF. (OR 19.2 S.J.)
LOWER VENTILATION PROVIDED:
(1) SERND VENTS & 46 SI.
46 SI. PROVIDED › 19.2 5.I. REQD.

AREA 12 - LOWER VENTILATION REQUIRED:
15 SF ATTIC AREA / 150 = 01 SF (OR 44 SI)
LOWER VENTILATION PROVIDED:
11) SORND. VENTS € 46 S.I.
46 SI. PROVIDED › 14.4 SI. REQD.

AREA I3 - LOWER VENTILATION REQURED
19 S.F. ATTIC AREA / 150 = 013 SF. (OR 182 SI)
LOWER VENTILATION PROVIDED:
(1) SCRND. VENTS € 46 5.1.
46 SI. PROVIDED › 18.2 SI. REQD.

AREA 14 - LOWER VENTILATION REQUIRED:
20 SF. ATTIC AREA / 150 = 0.13 SF. (OR 19.2 5.1)
LOWER VENTILATION PROVIDED.
(1) SORND. VENTS a 46 SI.
46 SI. PROVIDED › 19.2 5.I. REQ'D

AREA 15 - LOWER VENTILATION REQUIRED
19 SF. ATTIC AREA / 50 = 01 5F. (OR 1632 SI)
LOWER VENTILATION FROVIDED:
(1) SCRND. VENTS € 46 S.I.
46 SI. PROVIDED › 16.32 S.I. REQD

AREA 16 - LOWER VENTILATION REQUIRED
17 SF. ATTIC AREA / 50 = OII SF. (OR 1632 SI)
LOWER VENTILATION PROVIDED:
(1) SCRND. VENTS @ 46 S.I.
46 SI PROVIDED › 16 32 SI REOD

ACME ARCHITECTS

Acme Architects, Inc.
Architecture / Planning

3361 Walnut Blvd. Ste. 120
Brentwood, CA 94513
(925) 634-7000

The Preserve & Salt Court Townhomes

Redwood City, CA

Conceptual design by Acme Architects

Roof Plan & Attic Vent Calc.

Revisions

⚠1 Plan check comments: 09-24-2022

B1 RSOA comments: 07-28-2021

SET DATE:	01-22-2022
ISSUE DATE:	07-28-2021
SCALE:	As noted
DRAWN:	JLR, JSC, TW
JOB	310392

PM: JR **QC:** JR **OL:** TW

PLAN **BLDG** SHEET .1C OF SHEETS

DO NOT SCALE THESE DRAWINGS





FRONT ELEVATION

Scale: 3/16" = 1'-0"



ALT. FRONT ELEVATION

Scale: 3/16" = 1'-0"



LEFT ELEVATION

Scale: 3/16" = 1'-0"



ALT. RIGHT ELEVATION

Scale: 3/16" = 1'-0"



RIGHT ELEVATION

Scale: 3/16" = 1'-0"



ALT. REAR ELEVATION

Scale: 3/16" = 1'-0"

REAR ELEVATION

Scale: 3/16" = 1'-0"

ACME ARCHITECTS

Acme Architects, Inc.
Architecture / Planning

3361 Walnut Blvd. Ste. 120
Brentwood, CA 94513
(925) 634-7000

The Preserve & Salt Court Townhomes

Redwood City, CA

Conceptual design by Acme Architects

Exterior Elevations

Revisions

1 Plan check comments: 09-24-2021

2 Client revisions / RSOA comments 11-18-2021

B1 RSOA comments: 07-28-2021

3 Framewalk revisions: 01-22-2022

SET DATE:	01-22-2022
ISSUE DATE:	07-28-2021
SCALE:	As noted
DRAWN:	JLR, JSC, TW
JOB	310392

PM: JR | **QC:** JR | **OL:** TW

PLAN **BLDG**

SHEET .1D

OF SHEETS

DO NOT SCALE THESE DRAWINGS