

PLAN REVIEW NOTES:

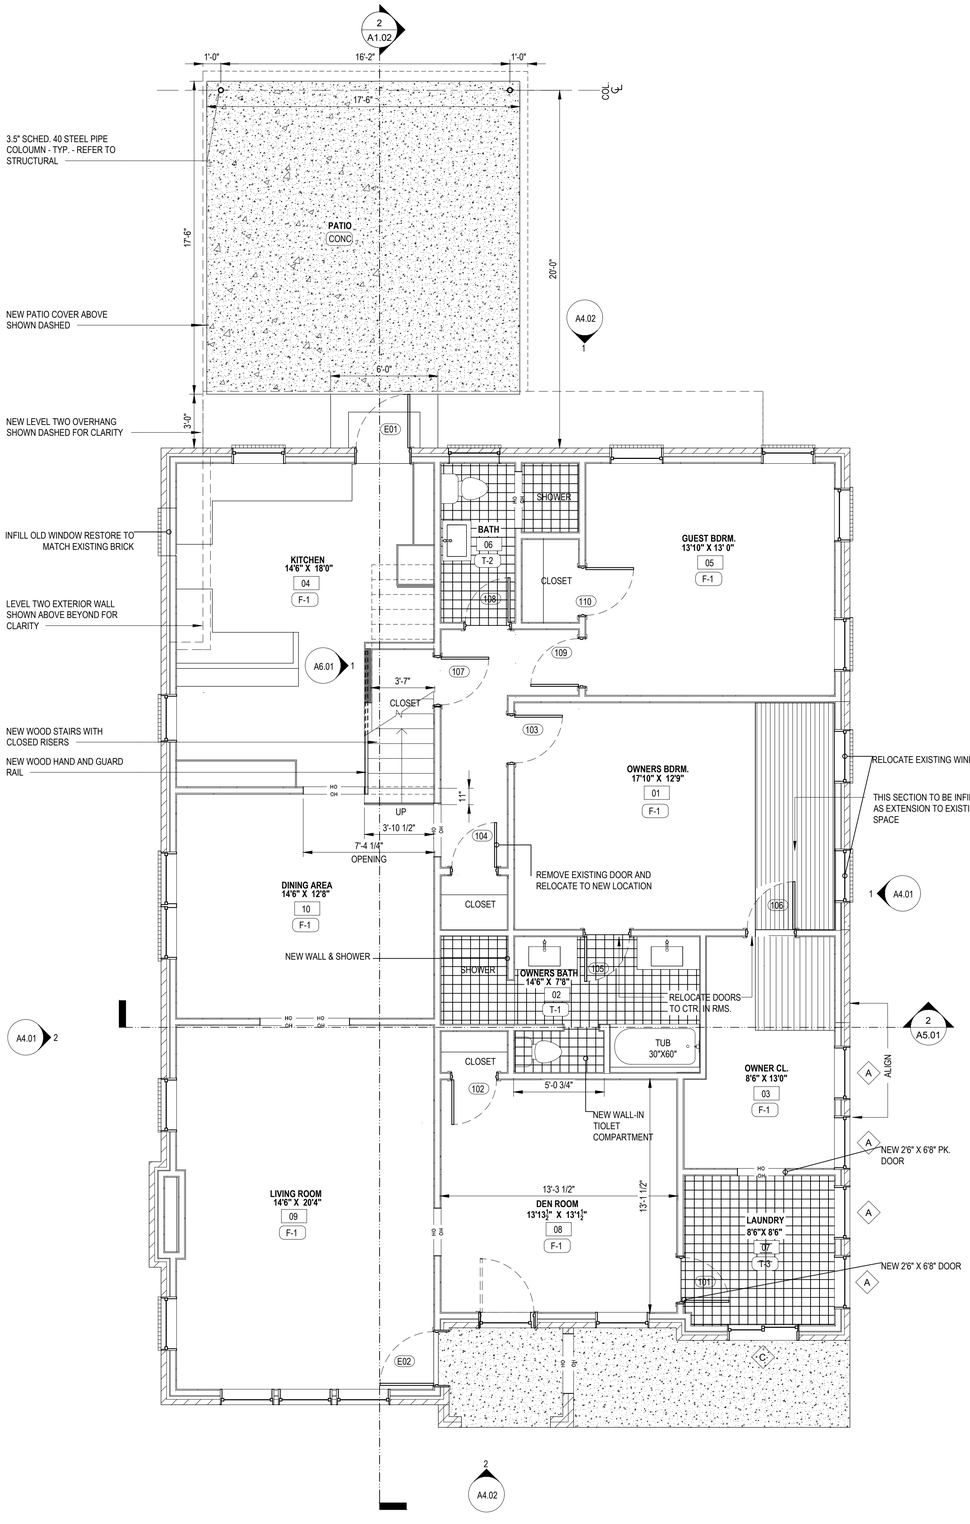

01 - FIRST FLOOR PLAN

NORTH

SCALE: 1/4" = 1'-0"

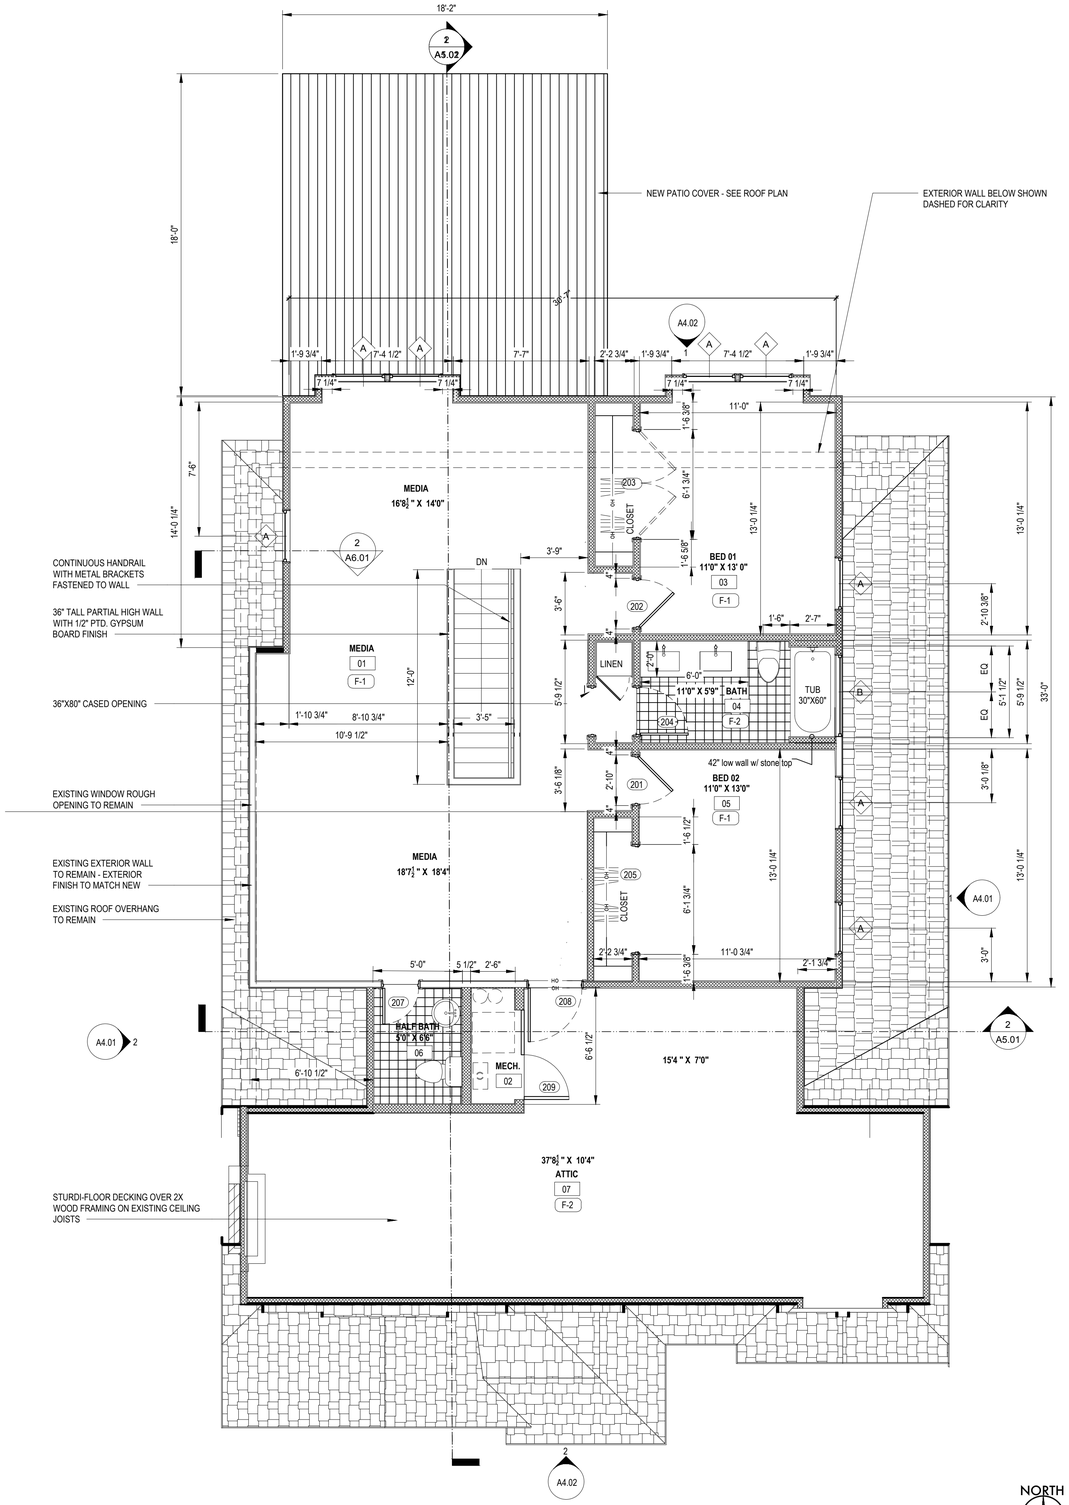

02 - SECOND FLOOR PLAN

NORTH

SCALE: 1/4" = 1'-0"

domi works
architecture + interior design
construction

LICENCE SEAL LOCATION:

REGISTERED ARCHITECT
BLAINE E. LADIMON
26614
STATE OF TEXAS

SIGNED:11/08/2021

ARCHITECTURE/ INTERIOR DESIGN
domi works llc
7929 CHURCHILL WAY
DALLAS,TEXAS 75251
OFF:214.882.2867
blane@domiworks.co

STUCKEY RESIDENCE

PROJECT ADDRESS:

5451 VANDERBILT AVE.
DALLAS, TEXAS 75206

GREENVILLE CREST
#1:BLK K/2179 PT LT 17

GENERAL CONTRACTOR:

domi works llc
7929 CHURCHILL WAY
DALLAS,TEXAS 75251
OFF:214.882.2867
blane@domiworks.co

ISSUE DATES:

C.D. ISSUE ADD.:
SEPT. 29, 2021
NOV. 08, 2021

AS BUILT PLANS

A1.1A